GOVERNING CODES

VICINITY MAP

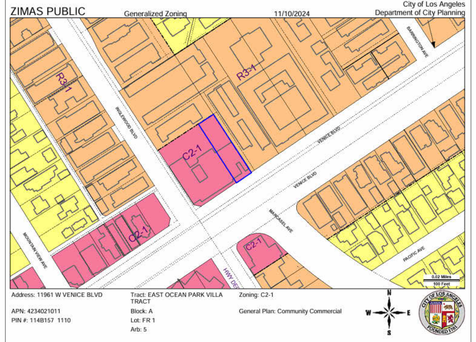

PROJECT DATA

Adress:
11961 VENICE BLVD
LOS ANGELES CA 90066

Year:1963

Land SqFt: 11,773

Land W' x D': 61' x 193'

Legal Description (for assessment purposes)::

LAND DESC IN DOC 004710, 76-4-16*TR= EAST OCEAN PARK VILLA TRACT* POR OF LOTS 1 AND LOT 3 BLK A

Zone: C2-1

SCOPE OF WORK

AS BUILT

#	SHEET	INDEX SHEET
1	G001	PROJECT INFORMATION
2	A000	SITE PLAN
3	A001	FLOOR PLAN
4	A002	SIDE VIEWS ELEVATIONS
5	A003	ROOF PLAN
-	-	
-	-	
-	-	
-	-	
-	-	
-	-	
-	-	
-	-	
-	-	

REVISIONS

-	-	-	-	-	-
A	A	A	A	A	A
-	-	-	-	-	-
A	A	A	A	A	A

INNOV projects
http://www.innovprojects.com

xxxxxxxxx
11961 VENICE BLVD
LOS ANGELES, CA. 90066

DRAW BY: -
CHECK BY: -
DATE: -
PROJECT NO: -

G001
01 OF 05